
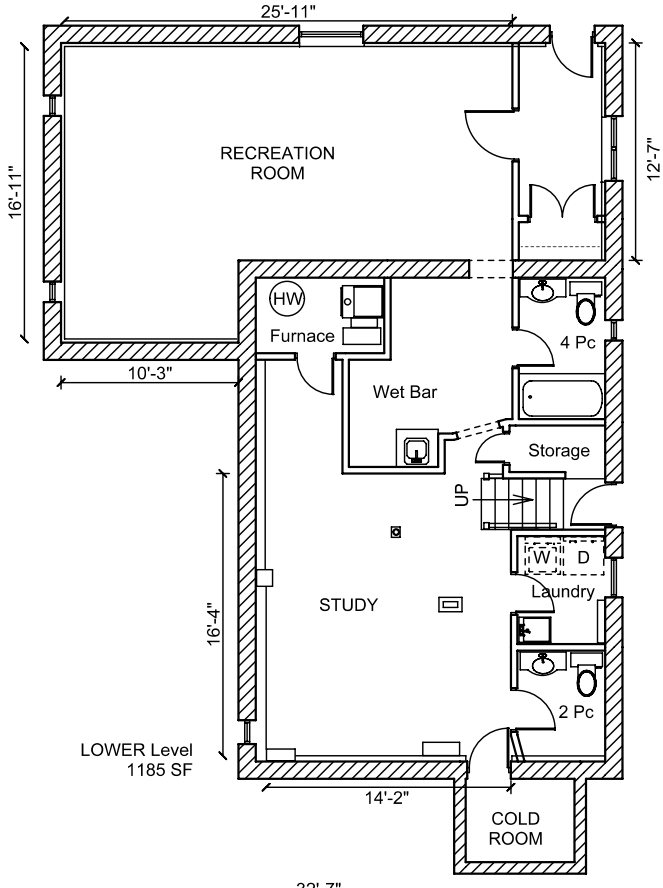


AS-BUILT PLANS

61Clissold.com


ROYAL LePAGE
 416.236.1871
 www.WhereTrustBegins.com

LIZ + JOHN STEVENSON
 Sales Representatives
 Royal LePage Real Estate Services Ltd.
 Brokerage



Plan, Area and Dimensions are Approximate.
 Provided as a convenience and guideline only.
 Copyright by John Stevenson (416) 233-8657

