

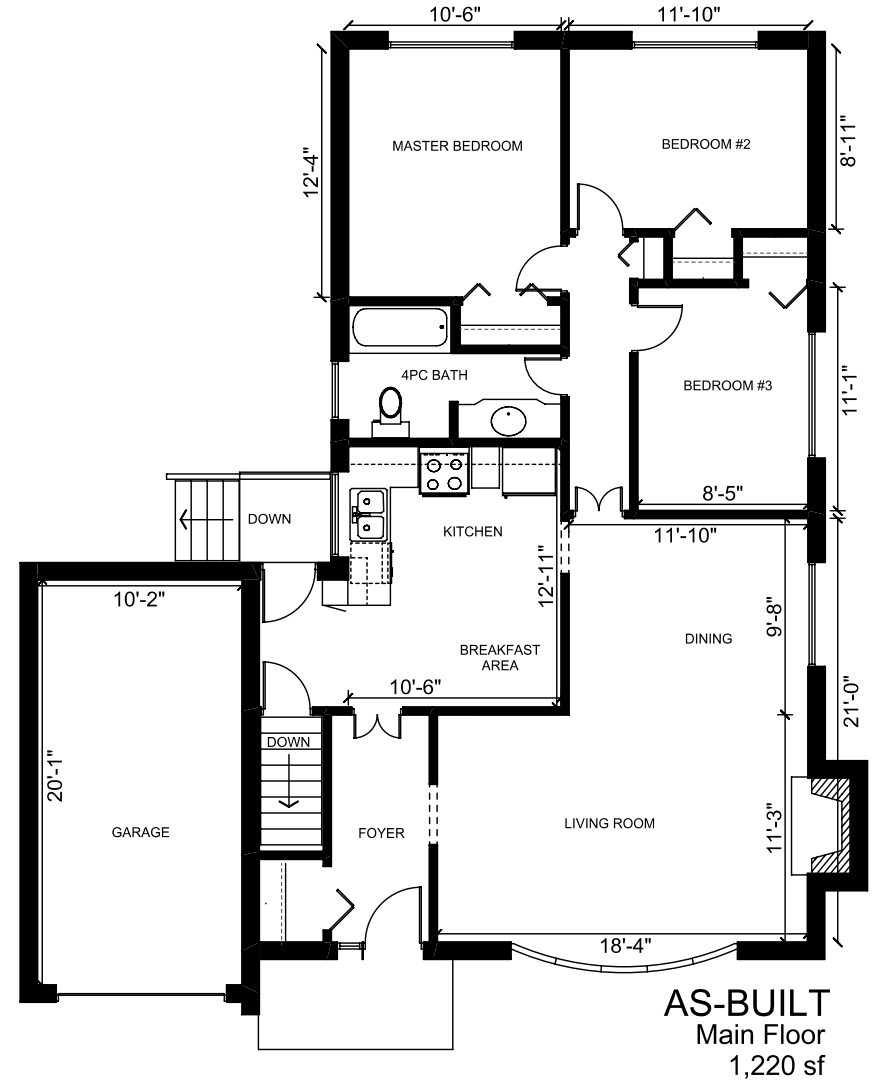
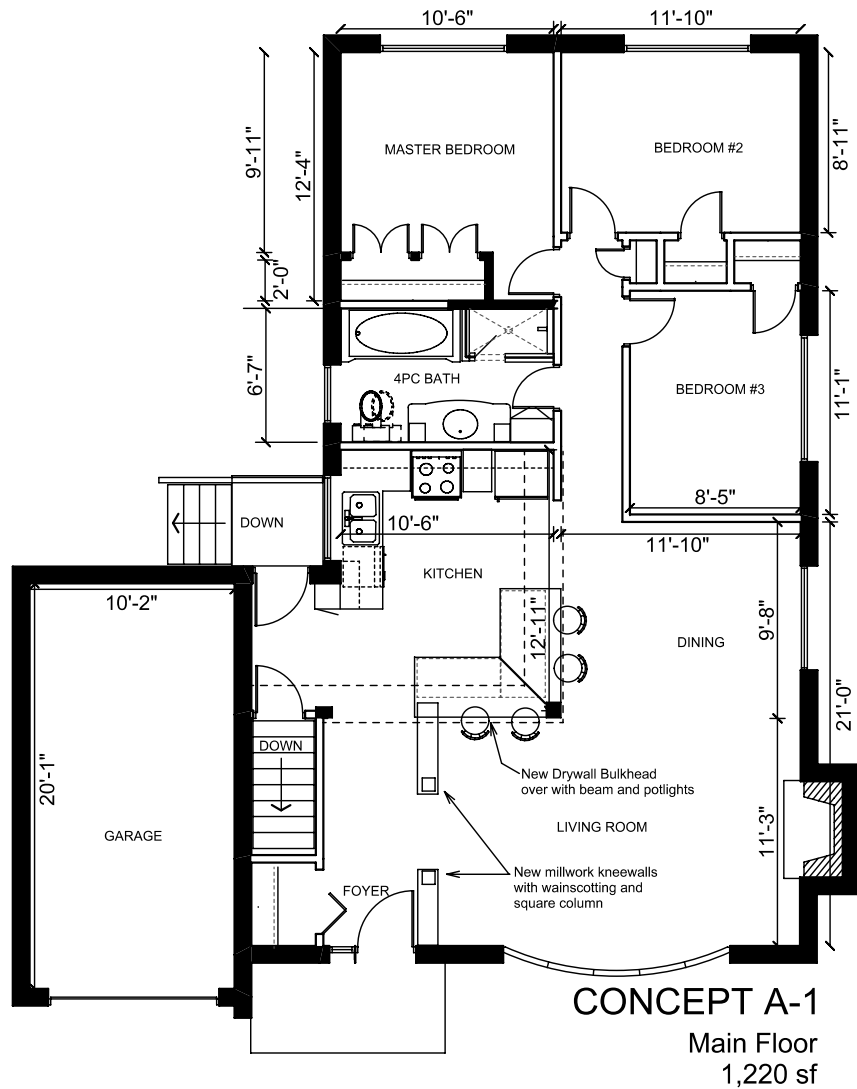


CONCEPT plans have been prepared for discussion and review purposes only and must not be relied upon for accuracy or feasibility. The Buyer of this home should not base a decision to buy this home based on the concept plans, and should seek appropriate advice from their own designers, consultants and contractors. The plan has not been reviewed for structural engineering considerations and may not be achievable. No representation is made as to the accuracy or suitability of these plans for building purposes.


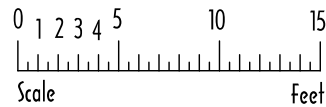


EXISTING Plan, Area and Dimensions are Approximate.
Provided as a convenience and guideline only.
Copyright by John Stevenson (416) 233-8657


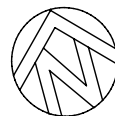


120WestDeanePark.com

CONCEPT plans have been prepared for discussion and review purposes only and must not be relied upon for accuracy or feasibility. The Buyer of this home should not base a decision to buy this home based on the concept plans, and should seek appropriate advice from their own designers, consultants and contractors. The plan has not been reviewed for structural engineering considerations and may not be achievable. No representation is made as to the accuracy or suitability of these plans for building purposes.

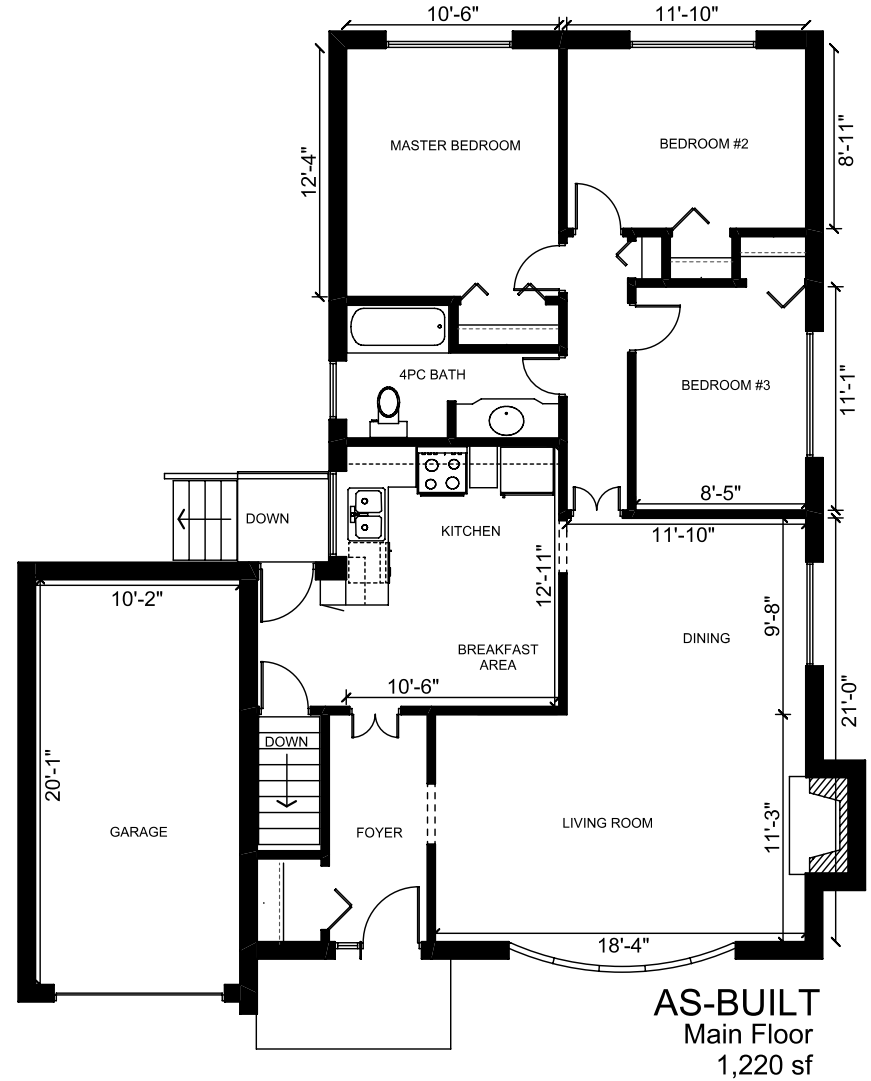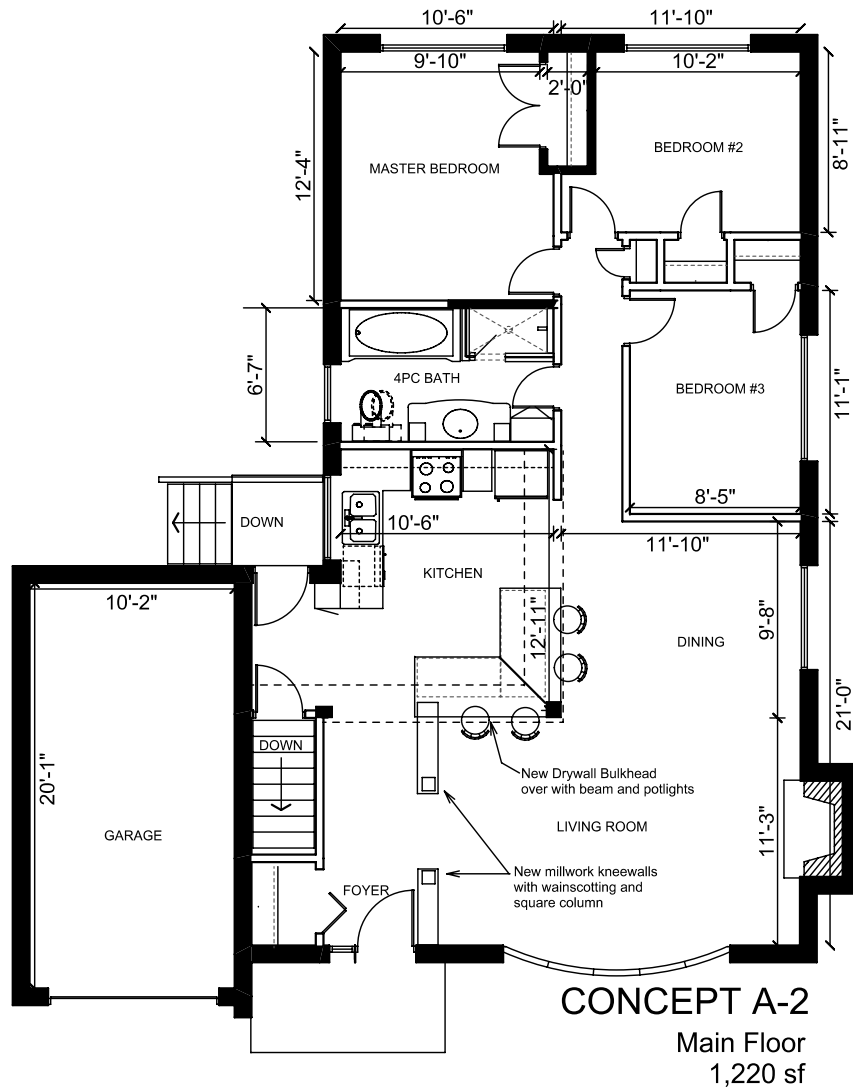


EXISTING Plan, Area and Dimensions are Approximate.
Provided as a convenience and guideline only.
Copyright by John Stevenson (416) 233-8657

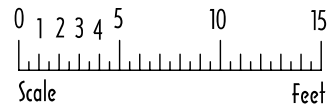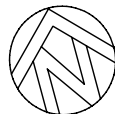


120WestDeanePark.com

Virtual Tour, Photos and Feature Sheet at ... 120WestDeanePark.com

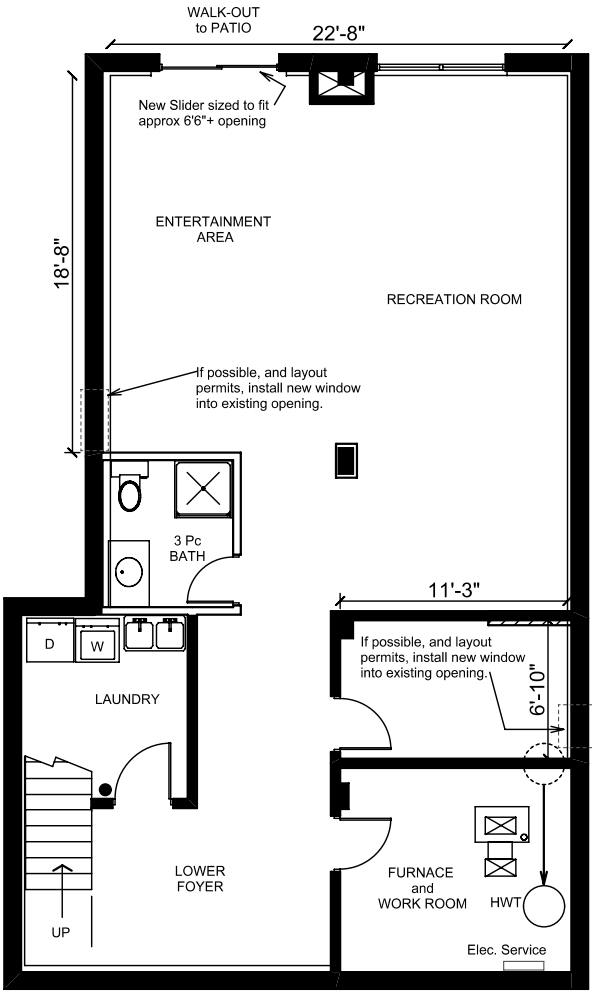


CONCEPT B

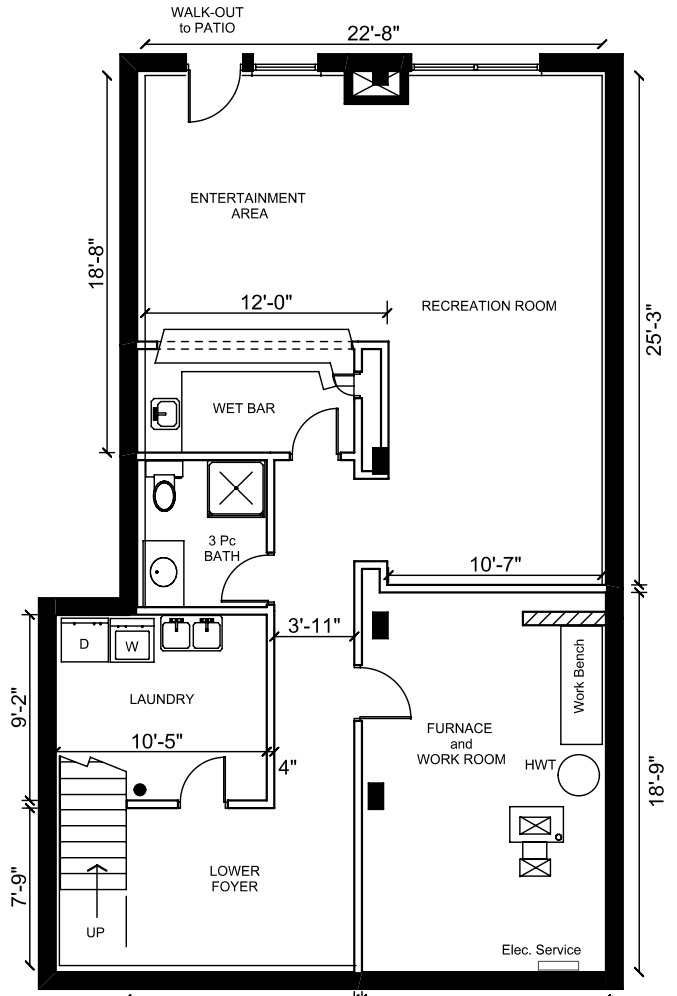

AS-BUILT

Lower Level
1,220sf

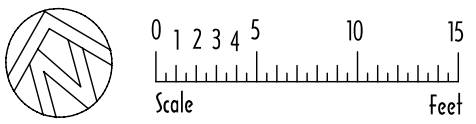

EXISTING Plan, Area and Dimensions are Approximate.
Provided as a convenience and guideline only.
Copyright by John Stevenson (416) 233-8657