

Virtual Tour, Photos and Feature Sheet at ...

# 6HumberRidge.com




LIZ & JOHN STEVENSON  
Sales Representatives

StevensonLINKS.com

RealEstateRemarkable.ca



ROYAL LEPAGE  
Real Estate Services Ltd. Brokerage  
416.236.1871

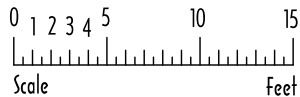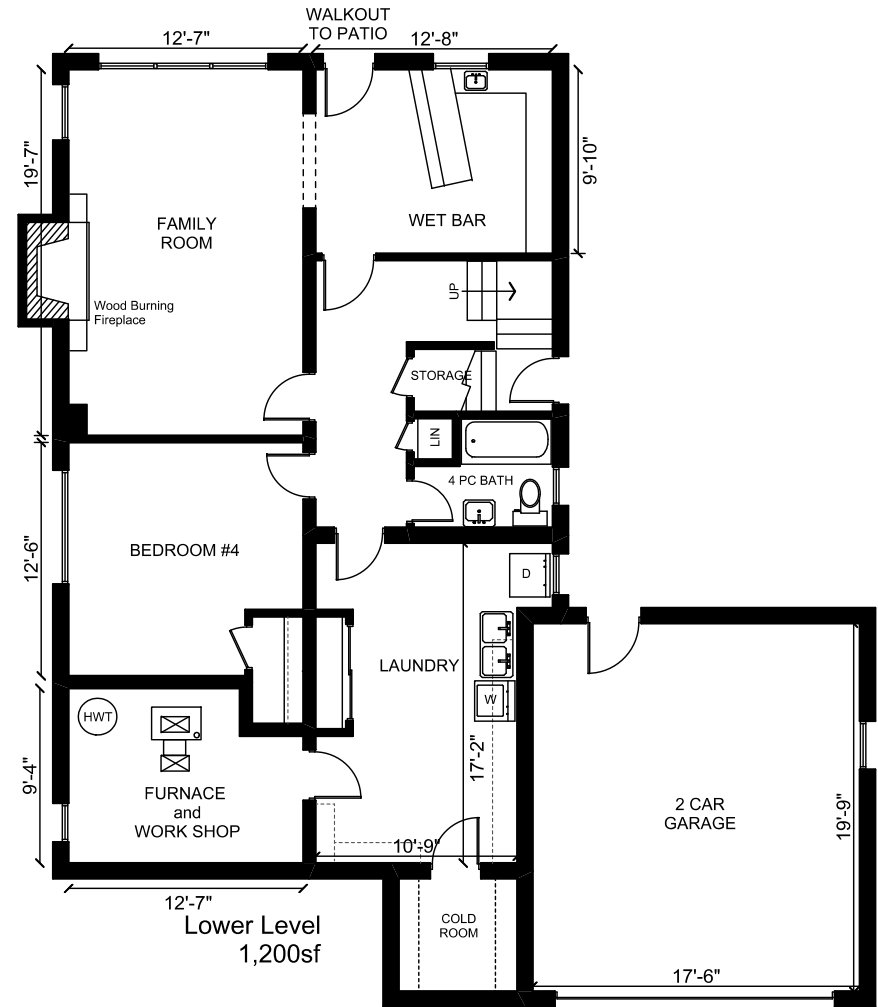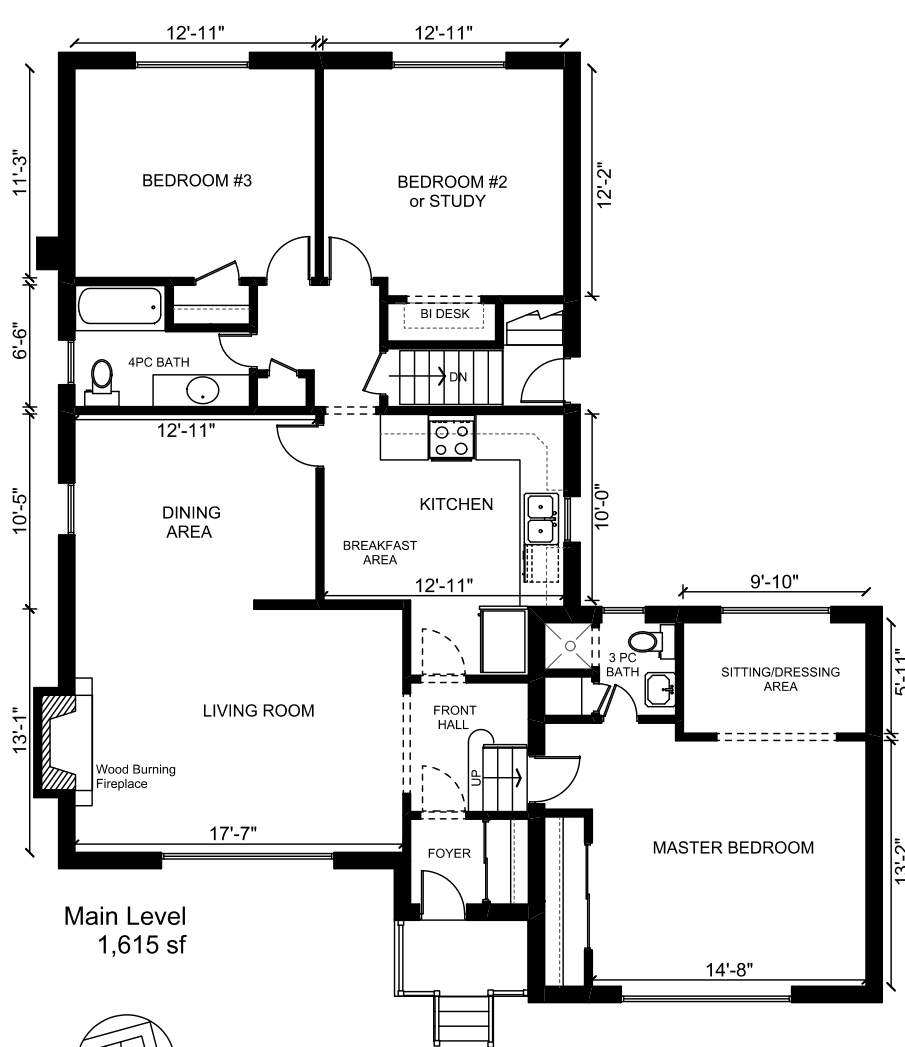


Plan, Area and Dimensions are Approximate.  
Provided as a convenience and guideline only.  
Copyright by John Stevenson (416) 233-8657


MAIN LEVEL:	1,615
LOWER LEVEL:	1,200
<b>TOTAL:</b>	<b>2,815 sf</b>

# CONCEPT PLANS

Prepared by John Stevenson 416.233.8657

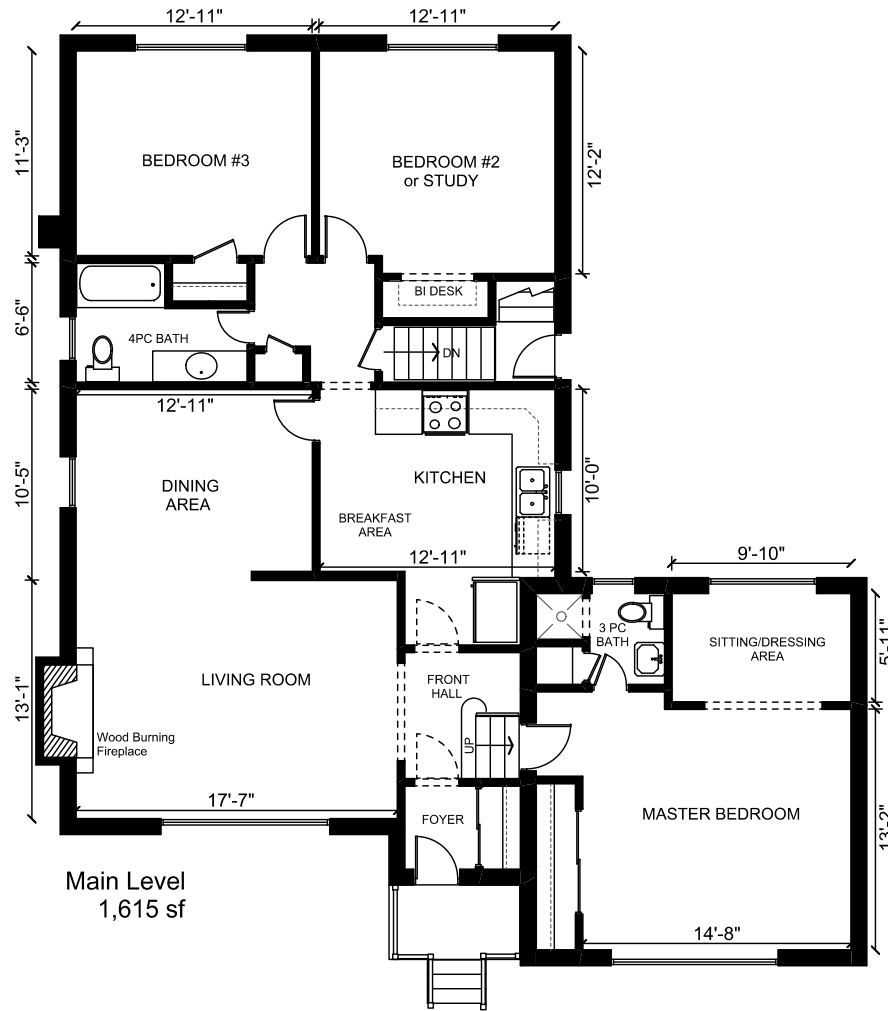

AS-BUILT

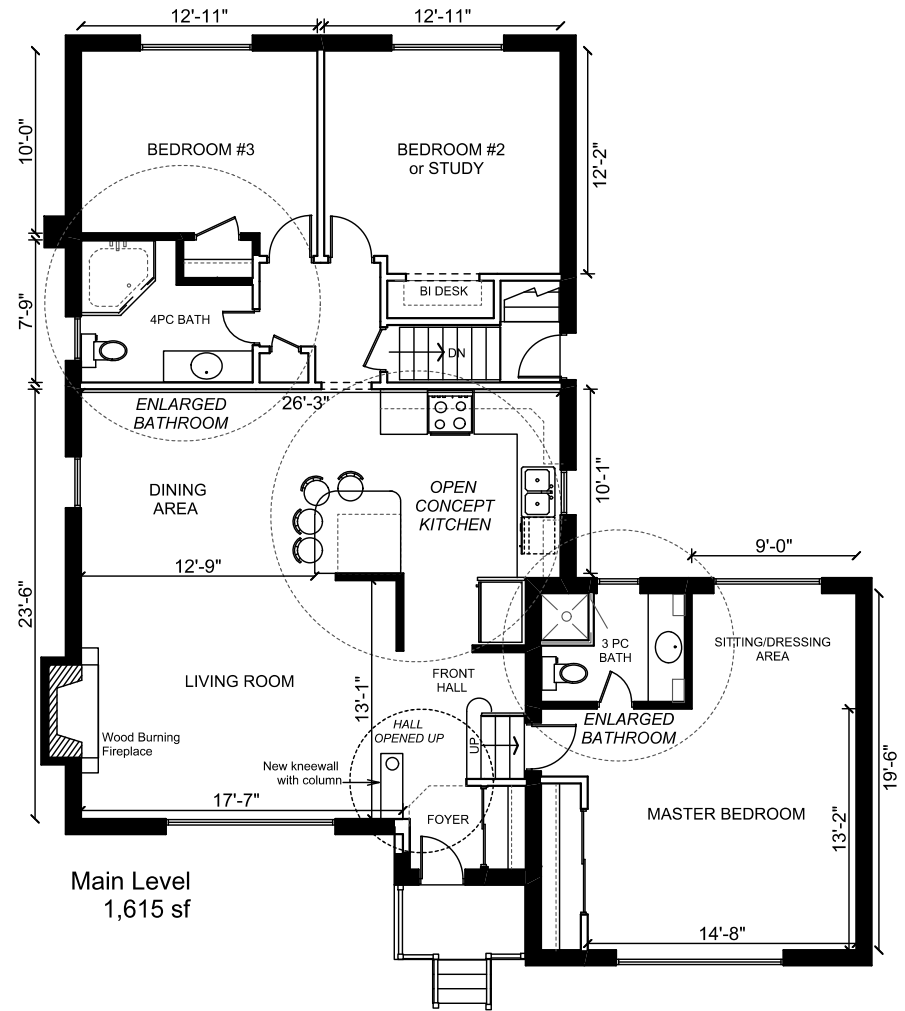

CONCEPT A

Virtual Tour, Photos and Feature Sheet at ...

[6HumberRidge.com](http://6HumberRidge.com)

Concept plans have been prepared for discussion and review purposes only and must not be relied upon for accuracy or feasibility. The Buyer of this home should not base a decision to buy this home based on the concept plans, and should seek appropriate advice from their own designers, consultants and contractors. No representation is made as to the accuracy or suitability of these plans for building purposes.

rev 2  
jan 6 2010